

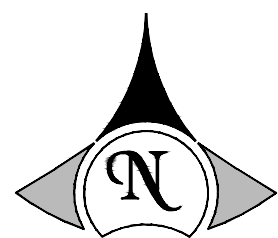


FILE NAME: H:\gh1\AutoCAD\3-14 Elevation View.dwg PLOTTED DATE: 3/21/2025 9:06 AM PLOTTED BY: Carter Hoag

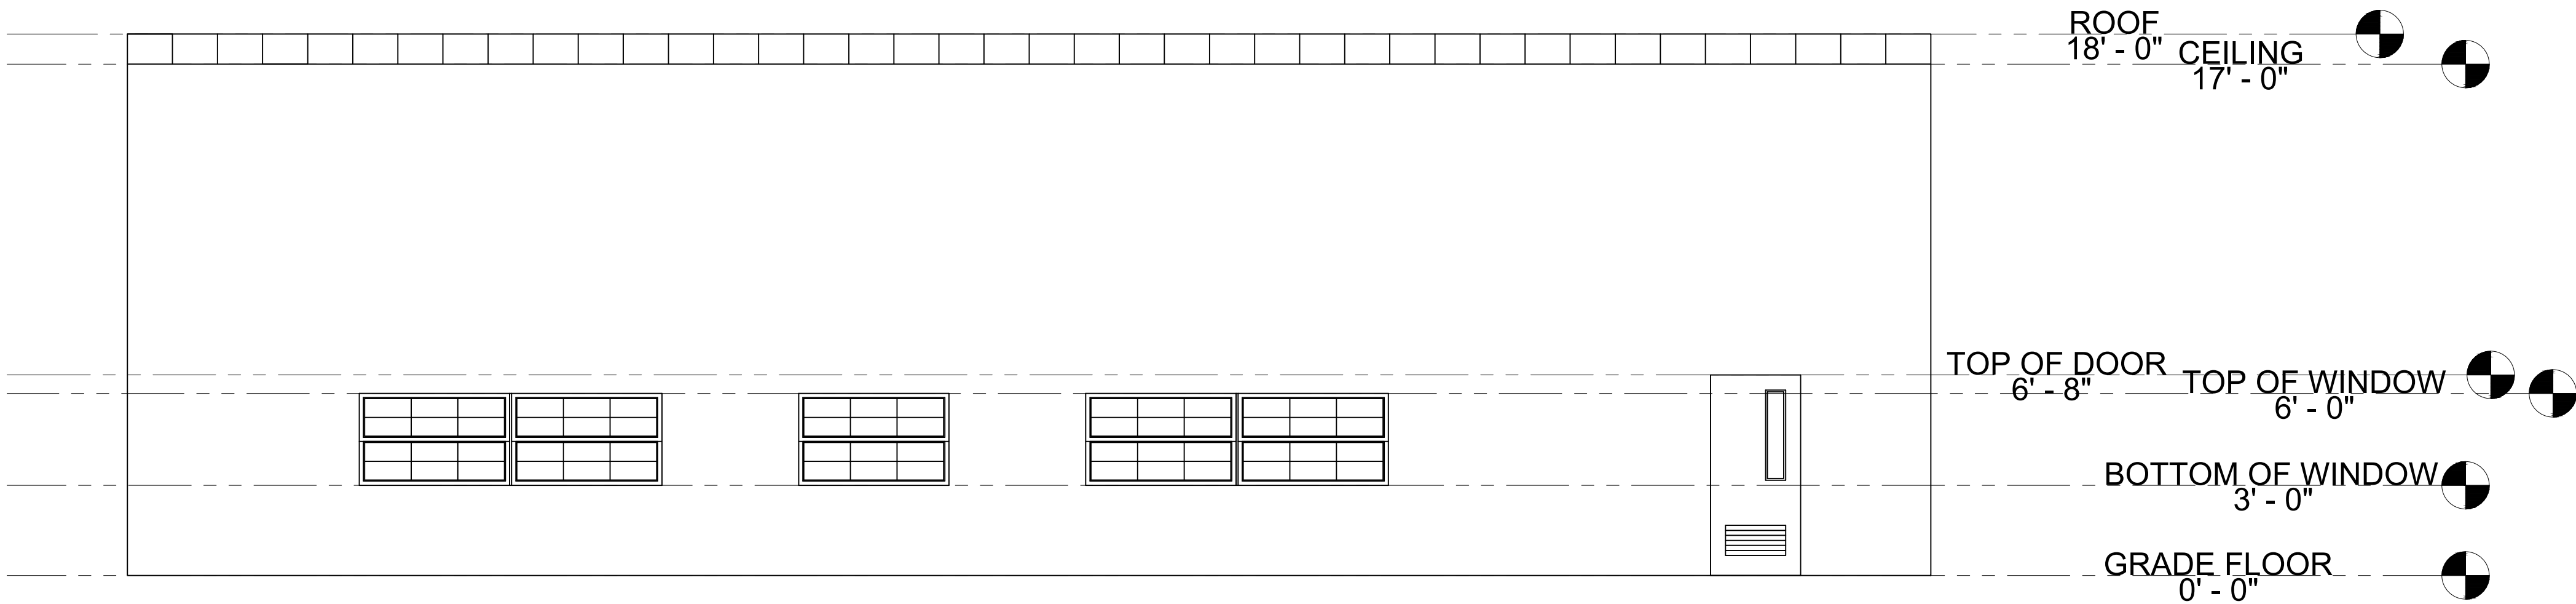


SOUTH ELEVATION
SCALE: 1/4" = 1'-0"

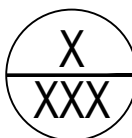

DETAIL NAME
SCALE: NONE




PROJECT ENGINEERING DEPARTMENT
1201 S. WASHINGTON AVE., LANSING, MICHIGAN 48910

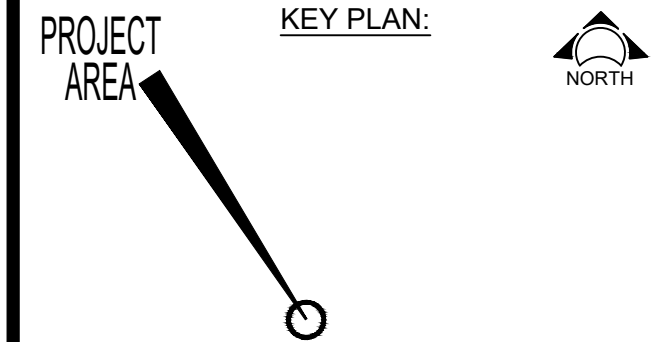

REVISIONS:					
REV.	DESCRIPTION	BY	CHK	APP	DATE
A	PRELIMINARY FOR REVIEW	-	-	-	XX-XX-XXX
B	PRELIMINARY FOR BID	-	-	-	XX-XX-XXX
0	FOR CONSTRUCTION	-	-	-	XX-XX-XXX
1	AS-BUILT	-	-	-	XX-XX-XXX

DRAWING
STATUS

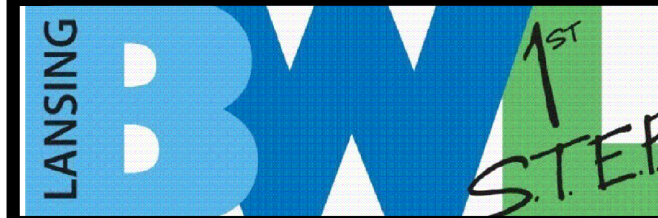

DATE:	3/20/2025	DWG BY:	CJH
CHK BY:	OWEN FEDEWA	APPR BY:	TECH LEADER
PROJ. NO:	1ST S.T.E.P.	STATUS:	RECORD

PROJECT NAME:
2025 PED-1ST S.T.E.P.
CARTER HOAG

DRAWING TITLE:
SINGLE STORY
OFFICE BUILDING

SITE:	-
STR/AREA:	-
DISCIPLINE:	-
FLOOR:	-

CONSULTANT DRAWING NUMBER: FOR MENTORING ONLY	BWL DRAWING NUMBER: MA-#CJH	REVISION: -
--	--------------------------------	----------------